

IN RE: PETITION FOR SPECIAL HEARING BEFORE THE DEPUTY ZONING COMMISSIONER
 SE 1/4 Chickentown Road, 709' SW of North Ruhl Road (2615 Chickentown Road) 6th Election District 3rd Councilmanic District
 CYNTHIA E. RILEY, et al Petitioners
 DEPUTY ZONING COMMISSIONER OF BALTIMORE COUNTY
 Case No. 89-428-SPH

FINDINGS OF FACT AND CONCLUSIONS OF LAW

The Petitioners originally requested a special hearing to approve the addition of a .97 acre parcel to an adjoining, separately deeded, .46 acre parcel, in order for the building right of the .46 acre parcel to be utilized and the Baltimore County Health Department regulations for well and septic systems to be adhered to, as more particularly described on the plan submitted and identified as Petitioner's Exhibit 1.

At a hearing held on May 3, 1989, the Petitioners, by Cynthia E. Riley and Gregory S. Cornwell, appeared, testified, and were represented by Julius W. Lichter, Esquire and Howard Alderman, Esquire. Also appearing on behalf of the Petition was Russell Bell, a nearby property owner. There were no Protestants.

Testimony indicated that the subject property, known as 2615 Chickentown Road, consists of three proposed lots, Lot 1 containing 10.0 acres, Lot 2 containing 1.43 acres, and Lot 3 containing 2.26 acres, all zoned R.C. 2. Lot 3 is currently developed with a two story single family dwelling and detached garage. Lots 1 and 2 are proposed for development with single family residences. Petitioners purchased 16.24 acres of R.C. 2 land located off of Chickentown Road in northern Baltimore County on November 30, 1988. Said property has been a parcel of record since October 1951. Chickentown Road runs through a rear portion of the site, sepa-

rating 3.01 acres more or less of the subject property from the remaining acreage. Mrs. Riley testified that, based upon her discussions with personnel in the Zoning Office and simultaneous to their purchase of the property, the Petitioners transferred the 3.01 acres to William and Liva Smith in exchange for a parcel of land owned by them located on the other side of Chickentown Road and contiguous to the remaining portion of Petitioner's property which contained 0.46 acres more or less. Said parcel was a parcel of record obtained by William Smith in June, 1975 and recorded in the land records of Baltimore County in June 1979. At the time of said transfer of the 3.01 acres to the Smiths, the deed referenced the transfer of the acreage as a non-density transfer for agricultural purposes. The original parcels and proposed parcels have been clearly depicted in Petitioner's Exhibit 2.

Subsequent to the May 3, 1989 hearing, it was agreed by all parties present that the hearing would be continued and Petitioners filed a revised Petition for Special Hearing to approve the transfer of density across a public road. The hearing on the amended Petition was held on September 19, 1989.

Testimony presented indicated Mr. Smith had been farming the 3.01 acres prior to its transfer and that he was extremely pleased with the transfer as the 3.01 acres could be farmed by him in contrast to the .46 acres, which was and would remain wooded. Mr. Cornwell, who currently is a part-time farmer with twelve years farming experience, testified that if the requested relief was granted, the spirit and intent of the R.C. zoning regulations would be met as the subdivision of the parcels provides for continued agricultural use. Petitioners agreed to file a plat in the land records of Baltimore County, which states that the parcels as set forth in

Petitioner's Exhibit 2, now owned by Petitioners, shall have no more than three density units and that said plat will be acknowledged by Mr. & Mrs. Smith verifying the 3.01 acres transferred to them shall be a non-density transfer for agricultural purposes only.

Counsel for Petitioners argued that the proposed relief was consistent with the Zoning Office's policy as set forth in R.S.D. 7 and met the spirit and intent of the Baltimore County Zoning Regulations (B.C.Z.R.), and the purpose of the R.C. 2 regulations for agricultural preservation.

Mr. Bell, a property owner of land further down Chickentown Road, testified as to his concerns with the proposed development of residential dwelling units in the area would have an adverse effect on agricultural uses. Mr. Bell noted the narrowness of Chickentown Road and feared the future placement of fences along the property lines which he argued would interfere with the ingress and egress of farm equipment from Ruhl Road onto Chickentown Road. Petitioners agreed that if any fencing were erected, it would be set back so as not to interfere with the farm equipment.

After due consideration of the testimony and evidence presented, it is clear the relief requested is appropriate and that practical difficulty would result if the special hearing were not granted. It has been established that the requirements from which the Petitioner seeks relief would unduly restrict the use of the land due to the special conditions unique to this particular parcel. In addition, the relief requested will not be detrimental to the public health, safety, and general welfare.

Pursuant to the advertisement, posting of the property, and public hearing on this Petition held, and for the reasons given above, the special hearing should be granted.

THEREFORE, IT IS ORDERED by the Deputy Zoning Commissioner for Baltimore County this 11th day of January, 1990 that the Petition for Special Hearing to approve the transfer of density from Parcel A on Petitioner's Exhibit 2 across the public road and the addition of a .97 acre parcel to an adjoining, separately deeded, .46 acre parcel, in accordance with Petitioner's Exhibit 2, be and is hereby GRANTED, subject, however, to the following restrictions:

- 1) The Petitioners may apply for their building permit and be granted same upon receipt of this Order; however, Petitioners are hereby made aware that proceeding at this time is at their own risk until such time as the 30-day appellate process from this Order has expired. If, for whatever reason, this Order is reversed, the Petitioners would be required to return, and be responsible for returning, said property to its original condition.
- 2) Petitioners shall have a new record plat recorded in the Land Records for Baltimore County depicting the parcels as set forth in Petitioner's Exhibit 2 and specifying the following:
 - a) The 3.01 acres shall contain no density units now and forever and shall be used for agricultural purposes only.
 - b) Petitioners agree that Lots 1, 2 and 3, as depicted in Petitioner's Exhibit 2, shall contain only three (3) density units, one (1) density unit per lot, unless the B.C.Z.R. are hereafter amended and additional density units are permitted as of right under the newly adopted regulations.
 - c) Lots 1 and 2 shall be used for agricultural purposes and the proposed dwellings shall be situated so as not to interfere with prime and productive soils as determined by the Baltimore County Department of Environmental Protection and Resource Management and the Office of Planning.
 - d) There shall be no structures of any nature, including, but not limited to, fences, erected within 15 feet of either side of Chickentown Road.
 - e) The new plat shall be signed by Petitioners and Mr. & Mrs. Smith and recorded in the Land Records for

ORDER RECEIVED FOR FILING
 Date 1/11/90
 By [Signature]

ORDER RECEIVED FOR FILING
 Date 1/11/90
 By [Signature]

ORDER RECEIVED FOR FILING
 Date 1/11/90
 By [Signature]

Baltimore County within forty-five (45) days of the date of this Order.
 4) Compliance with all Baltimore County Health Department regulations regarding development of Lots 1 and 2, including, but not limited to, well and septic systems.
 5) Petitioners shall make reference to this case and the conditions and restrictions contained herein in all transfers of any portion of the subject property.
 6) When applying for a building permit, the site plan and landscaping plan filed must reference this case and set forth and address the restrictions of this Order.

ANN M. NASTAROWICZ
 Deputy Zoning Commissioner
 for Baltimore County

PETITION FOR SPECIAL HEARING TO THE ZONING COMMISSIONER OF BALTIMORE COUNTY.

The undersigned, legal owner(s) of the property situate in Baltimore County and which is described in the description and plat attached hereto and made a part hereof, hereby petition for a Special Hearing under Section 500.7 of the Baltimore County Zoning Regulations, to determine whether or not the Zoning Commissioner and/or the Zoning Board should approve an amendment to the relief requested in Case No. 89-428-SPH to permit the transfer of density across a public road.

Property is to be posted and advertised as prescribed by Zoning Regulations.
 I, or we, agree to pay expenses of the above Special Hearing advertising, posting, etc., upon filing of this Petition, and further agree to and are to be bound by the zoning regulations and restrictions of Baltimore County adopted pursuant to the Zoning Law for Baltimore County.

Legal Owner(s):
 Cynthia E. Riley
 Gregory S. & Carol M. Cornwell
 Julius W. Lichter, Esquire

BALTIMORE COUNTY, MARYLAND
 OFFICE OF FINANCE - REVENUE DIVISION
 MISCELLANEOUS CASH RECEIPT
 DATE 6/27/89 AMOUNT \$ 3
 RECEIVED FROM LEVIN & GANN
 FOR REVISED SPH PETITION

19204 York Road 329-8055
 Parkton, MD 21120
 City and State
 Name, address and phone number of legal owner, contract purchaser or representative to be contacted
 Julius W. Lichter, Esquire
 Name 305 W. Chesapeake Ave, Ste. 113
 Towson, Maryland 21204 321-0600
 Address Phone No.

ORDERED By the Zoning Commissioner of Baltimore County, this 29th day of June, 1989, that the subject matter of this petition be advertised, as required by the Zoning Law of Baltimore County, in two newspapers of general circulation throughout Baltimore County, that property be posted, and that the public hearing be had before the Zoning Commissioner of Baltimore County in Room 108, County Office Building in Towson, Baltimore County, on the 19 day of Sept, 1989, at 9:30 o'clock P.M.

J. Robert Hines
 Zoning Commissioner of Baltimore County

ORDER RECEIVED FOR FILING
 Date 1/11/90
 By [Signature]

ORDER RECEIVED FOR FILING
 Date 1/11/90
 By [Signature]

PARTICULAR DESCRIPTION OF A 0.971 ACRE TRACT

Beginning at a stone at the end of the front or S 25° E, 30.5 perch line which is recorded among the land records of Baltimore County in Liber No. 6039, Folio 53 dated June 25, 1929, 1179 thence S 55° 27' 26" W for a distance of 210.05 feet, thence N 21° 52' 29" W for a distance of 175.00 feet, thence N 39° 45' 09" E for a distance of 223.84 feet, thence with the centerline of Chicken Town Road for the next course, with a curve to the left in a southeasterly direction with a radius of 117.03 feet, an arc distance of 28.75 feet and being subtended by a chord S 37° 56' 07" E, 28.68 feet, thence S 21° 52' 29" E for a distance of 207.75 feet, to the point of beginning containing 42,332.14 square feet or 0.971 acres, more or less.

Being the same land, which by deed dated October 6, 1951, and recorded among the land records of Baltimore County in Liber No. 2024 Folio 377, was granted and conveyed by Frank H. Warns and Elizabeth C. Warns to Glenn Elwood McCullough and Jennie Irene McCullough.

Together with the buildings and improvements thereupon erected, made or being and all and every the rights, alleys, ways, waters, privileges, appurtenances, and advantages to the same belonging or any wire appertaining.

Subject to any and all easements, right-of-way, restriction as previously recorded and lease agreement.

CERTIFICATE OF POSTING ZONING DEPARTMENT OF BALTIMORE COUNTY

Towson, Maryland
 District 6th
 Date of Posting April 8-89
 Posted for: Special Hearing
 Petitioner: Cynthia E. Riley, Gregory and Carol Cornwell
 Location of property: SE side of Chickentown Road, 709' SW of North Ruhl Road, (2615 Chickentown Road)
 Location of Signs: 1. Location signs at the intersection of Chickentown Road and North Ruhl Road, and 1 sign on SE side of Chickentown Road, front of subject property.
 Remarks: [Blank]
 Posted by: J. Robert Hines
 Number of Signs: 2

CERTIFICATE OF PUBLICATION

TOWSON, MD. August 29, 1989
 IS TO CERTIFY, that the annexed advertisement was published in TOWSON TIMES, a weekly newspaper published in Baltimore County, Md., once in each of 1 successive first publication appearing on August 24, 1989.
 THE JEFFERSONIAN
 TOWSON TIMES,
 S. Zate Olson
 Publisher

PO 16241
 reg H 3430
 no 89-428-SPH
 price \$ 90.53

8823605W.D04

CERTIFICATE OF POSTING
ZONING DEPARTMENT OF BALTIMORE COUNTY
Towson, Maryland

89-428-SPH

District: 6th Date of Posting: August 30, 89

Posted for: Special Hearing

Petitioner: Cynthia E. Riley, et al.

Location of property: SE side of Chickentown Road, 709' SW of North Ruhl Road

Location of Sign: Location sign at the intersection of Chickentown Road and North Ruhl Road, approx. SE side of Chickentown Road in front of subject property

Remarks: Road in front of subject property

Posted by: D. J. Bell Date of return: September 1, 89

Number of Signs: 2

NOTICE OF HEARING

The Zoning Commissioner of Baltimore County, by authority of the Zoning Act and Regulations of Baltimore County will hold a public hearing on the property identified herein in Room 106 of the County Office Building, located at 111 W. Chesapeake Avenue in Towson, Maryland as follows:

Petition for Special Hearing
CASE NUMBER: 89-428-SPH
SES Chickentown Road, 709' SW of North Ruhl Road
2615 Chickentown Road
6th Election District - 3rd Councilmanic
Petitioner(s): Cynthia E. Riley, et al.
HEARING SCHEDULED: TUESDAY, SEPTEMBER 19, 1989 at 9:30 a.m.

Special Hearings To permit the transfer of density across a public road.

In the event that this Petition is granted, a building permit may be issued within the thirty (30) day appeal period. The Zoning Commissioner will, however, entertain any request for a stay of the issuance of said permit during this period for good cause shown. Such request must be in writing and received in this office by the date of the hearing set above or presented at the hearing.

J. Robert Haines
J. ROBERT HAINES
ZONING COMMISSIONER
BALTIMORE COUNTY, MARYLAND

cc: Cynthia E. Riley
Gregory S. & Carol M. Cornwell
Julius W. Lichter, Esq.
Russell Bell
File

PLEASE PRINT CLEARLY

PETITIONER(S) SIGN-IN SHEET	
NAME	ADDRESS
<u>Julius W. Lichter</u>	<u>305 W. Chesapeake Avenue 21204</u>
<u>GREGORY S. CORNWELL</u>	<u>10 Jordan Mill Ct White Hall MD 21161</u>
<u>CYNTHIA E. RILEY</u>	<u>1824 Park Rd. Parkton MD 21120</u>
<u>Howard L. Alderman, Jr.</u>	<u>305 W. Chesapeake Ave 21204</u>

PLEASE PRINT CLEARLY

PROTESTANT(S) SIGN-IN SHEET	
NAME	ADDRESS
<u>Russell Bell</u>	<u>Freehold Md 21053</u>

Baltimore County
Zoning Commissioner
Office of Planning & Zoning
Towson, Maryland 21204
(301) 887-3353

J. Robert Haines
Zoning Commissioner

DATE: 9/6/89

Julius W. Lichter, Esq.
305 W. Chesapeake Avenue, Suite 113
Towson, Maryland 21204

Re: Petition for Special Hearing
CASE NUMBER: 89-428-SPH
SES Chickentown Road, 709' SW of North Ruhl Road
2615 Chickentown Road
6th Election District - 3rd Councilmanic
Petitioner(s): Cynthia E. Riley, et al.
HEARING SCHEDULED: TUESDAY, SEPTEMBER 19, 1989 at 9:30 a.m.

Dear Sir:

Please be advised that \$115.53 is due for advertising and posting of the above captioned property.

THIS FEE MUST BE PAID AND THE ZONING SIGN AND POST SET(S) RETURNED ON THE DAY OF THE HEARING OR THE ORDER SHALL NOT BE ISSUED. DO NOT REMOVE THE SIGN AND POST SET(S) FROM THE PROPERTY UNTIL THE DAY OF THE HEARING.

Please make your check payable to Baltimore County, Maryland. Bring the check and the sign and post set(s) to the Zoning Office, County Office Building, 111 W. Chesapeake Avenue, Room 113, Towson, Maryland fifteen (15) minutes before your hearing is scheduled to begin.

Should you fail to return the sign and post set(s), there will be a charge for each such set.

Dennis F. Rasmussen
County Executive

BALTIMORE COUNTY, MARYLAND
OFFICE OF FINANCE - REVENUE DIVISION
MISCELLANEOUS CASH RECEIPT

No. 074413

DATE: 9/19/89 ACCOUNT: R-001-615-000

AMOUNT: \$ 115.53

RECEIVED FROM: Riley + Cornwell

FOR: P.A. 9/19/89 (# 89-428-SPH)

Dennis F. Rasmussen
County Executive

BALTIMORE COUNTY, MARYLAND
OFFICE OF FINANCE - REVENUE DIVISION
MISCELLANEOUS CASH RECEIPT

No. 087634

DATE: 5/3/89 ACCOUNT: R-01-615-000

AMOUNT: \$ 129.34

RECEIVED FROM: Levin & Gann, P.A.

FOR: P.A. 5/3/89 Hearing 89-428-SPH

Dennis F. Rasmussen
County Executive

CERTIFICATE OF PUBLICATION

TOWSON, MD., April 6, 1989

THIS IS TO CERTIFY, that the annexed advertisement was published in TOWSON TIMES, a weekly newspaper published in Towson, Baltimore County, Md., once in each of 1 successive weeks, the first publication appearing on April 6, 1989.

TOWSON TIMES,
S. Zeke Orlov
Publisher

PO 10919
reg M 27121
ca 89-428-SPH

LAW OFFICES
LEVIN & GANN
A PROFESSIONAL ASSOCIATION
305 W. CHESAPEAKE AVENUE
TOWSON, MARYLAND 21204
301-321-0600
FAX 301-296-2801

March 21, 1989

J. Robert Haines, Zoning Commissioner
Baltimore County Office of Planning and Zoning
111 West Chesapeake Avenue
Towson, Maryland 21204

RE: Petition for Special Hearing
Cynthia E. Riley, et al - Petitioners
Item No. 289

Dear Mr. Haines:

Please enter the appearance of Julius W. Lichter, Esquire, and Howard L. Alderman, Jr., Esquire, in the above referenced case on behalf of the Petitioners. In addition to any correspondence or notifications being sent to Petitioners, copies should also be forwarded to counsel.

Should you need additional information regarding this matter, please contact me.

Very truly yours,
Howard L. Alderman, Jr.
Howard L. Alderman, Jr.

HLA:rlsp

cc: Ms. Cynthia E. Riley
John Wayne, P.E.

Dennis F. Rasmussen
County Executive

BALTIMORE COUNTY
Zoning Commissioner
Office of Planning & Zoning
Towson, Maryland 21204
(301) 887-3353

J. Robert Haines
Zoning Commissioner

January 27, 1989

Cynthia E. Riley
Gregory S. & Carol M. Cornwell
19024 York Road
Parkton, MD 21120

RE: Petition for Special Hearing
Item #289
2615 Chickentown Road
6th Election District

Dear Ms. Riley & Mr. & Mrs. Cornwell:

I am in receipt of ten copies of the revised plans and three copies each of the zoning descriptions for the .971 acre parcel and the 1.43 acre parcel (.971 acre + .46 acre parcels). However, I cannot process this petition any further until I receive copies of all relevant deeds i.e., for the "straw dead", the .97 acre, .46 acre, 3.01 acre and the 13.23 acre tracts, etc.

Very truly yours,
John J. Sullivan, Jr.
JOHN J. SULLIVAN, JR.
Planning & Zoning Associate III

Dennis F. Rasmussen
County Executive

CERTIFICATE OF PUBLICATION

TOWSON, MD., April 6, 1989

THIS IS TO CERTIFY, that the annexed advertisement was published in THE JEFFERSONIAN, a weekly newspaper published in Towson, Baltimore County, Md., once in each of 1 successive weeks, the first publication appearing on April 6, 1989.

THE JEFFERSONIAN,
S. Zeke Orlov
Publisher

PO 10919
reg M 27121
ca 89-428-SPH
price \$114.34

NOTICE OF HEARING

The Zoning Commissioner of Baltimore County, by authority of the Zoning Act and Regulations of Baltimore County will hold a public hearing on the property identified herein in Room 106 of the County Office Building, located at 111 W. Chesapeake Avenue in Towson, Maryland as follows:

Petition for Special Hearing
CASE NUMBER: 89-428-SPH
SES Chickentown Road, 709' SW of North Ruhl Road
2615 Chickentown Road
6th Election District - 3rd Councilmanic
Petitioner(s): Cynthia E. Riley, Gregory and Carol Cornwell
HEARING SCHEDULED: WEDNESDAY, MAY 3, 1989 at 10:30 a.m.

Special Hearings: The addition of .97 ac. parcel to an adjoining .46 acre separately owned parcel (in order for the building right of the .46 acre parcel and septic to be adhered to. Both parcels are in an RC-2 zone and the 97 acre parcel will be coming from a larger tract which will be utilizing its two density units.

In the event that this Petition is granted, a building permit may be issued within the thirty (30) day appeal period. The Zoning Commissioner will, however, entertain any request for a stay of the issuance of said permit during this period for good cause shown. Such request must be in writing and received in this office by the date of the hearing set above or presented at the hearing.

J. Robert Haines
J. ROBERT HAINES
Zoning Commissioner of
Baltimore County

cc: Cynthia E. Riley
Gregory & Carol Cornwell
File

Dennis F. Rasmussen
County Executive

BALTIMORE COUNTY, MARYLAND
OFFICE OF FINANCE - REVENUE DIVISION
MISCELLANEOUS CASH RECEIPT

No. 087634

DATE: 5/3/89 ACCOUNT: R-01-615-000

AMOUNT: \$ 129.34

RECEIVED FROM: Levin & Gann, P.A.

FOR: P.A. 5/3/89 Hearing 89-428-SPH

Dennis F. Rasmussen
County Executive

89-428-SPH
BALTIMORE COUNTY OFFICE OF PLANNING & ZONING
County Office Building
111 W. Chesapeake Ave.
Towson, Maryland 21204

Your petition has been received and accepted for filing this
day of March, 1989

J. Robert Haines
ROBERT HAINES
ZONING COMMISSIONER

Received by: *James E. Dyer*
Chairman, Zoning Plans
Advisory Committee

Petitioner: Cynthia E. Riley, et al
Petitioner's Attorney: _____

cc: Mr. & Mrs. Gregory S. Cornwell
19024 York Road
Parkton, MD 21120

BALTIMORE COUNTY DEPARTMENT OF ENVIRONMENTAL
PROTECTION AND RESOURCE MANAGEMENT

3/23/89
Date

3/23/89
Date

Planning and Zoning
County Office Building
Towson, Maryland 21204

Meeting of February 28, 1989
Item # 289, Zoning Advisory Committee Meeting of February 28, 1989
Property Owner: Cynthia E. Riley, Gregory Cornwell, et al District: 6
Location: 2615 Chickentown Road
Per Supply: private Sewage Disposal: private

COMMENTS ARE AS FOLLOWS:

- Prior to approval of a Building Permit for construction, renovation and/or installation of equipment for any existing or proposed food service facility, complete plans and specifications must be submitted to the Plans Review Section, Bureau of Regional Community Services, for final review and approval.
- Prior to new installation(s) of fuel burning equipment, the owner shall contact the Bureau of Air Quality Management, 887-3775, to obtain requirements for such installation(s) before work begins.
- A permit to construct from the Bureau of Air Quality Management is required for such items as spray paint processes, underground gasoline storage tank(s) (5,000 gallons or more) and any other equipment or process which exhausts into the atmosphere.
- A permit to construct from the Bureau of Air Quality Management is required for any charbroiler generation which has a total cooking surface area of five (5) square feet or more.
- Prior to approval of a Building Permit Application for renovations to existing or construction of new health care facilities, complete plans and specifications of the building, food service area and type of equipment to be used for the food service operation must be submitted to the Plans Review and Approval Section, Division of Engineering and Maintenance, State Department of Health and Mental Hygiene for review and approval.
- Prior to any new construction or substantial alteration of public swimming pool, wading pool, bathhouse, saunas, whirlpools, hot tubs, water and sewage facilities or other amusements pertaining to health and safety; two (2) copies of plans and specifications must be submitted to the Baltimore County Department of Environmental Protection and Resource Management for review and approval. For more complete information, contact the Water Quality Monitoring Section, Bureau of Regional Community Services, 687-6500 x 315.
- Prior to approval for a nursery school, owner or applicant must comply with all Baltimore County regulations. For more complete information, contact the Division of Maternal and Child Health.
- If lubrication work and oil changes are performed at this location, the method providing for the elimination of waste oil must be in accordance with the State Department of the Environment.
- Prior to the tearing of existing structure(s), petitioner must contact the Division of Waste Management at 887-3775 regarding removal and/or disposal of potentially hazardous materials and solid wastes. Petitioner must contact the Bureau of Air Quality Management regarding removal of asbestos, 887-3775.
- Any abandoned underground storage tanks containing gasoline, waste oil, solvents, etc., must have the contents removed by a licensed hauler and tank removed from the property or properly backfilled. Prior to removal or abandonment, owner must contact the Division of Waste Management at 887-3745.
- Soil percolation tests, have been conducted.
- The results are valid until _____.
- Soil percolation test results have expired. Petitioner should contact the Division of Water and Sewer to determine whether additional tests are required.
- Where water wells are to be used as a source of water supply, a well meeting the minimum Baltimore County Standards must be drilled.
- In accordance with Section 13-1 of the Baltimore County Code, the water well yield test shall be valid until _____.
- is not acceptable and must be retested. This must be accomplished prior to conveyance of property and approval of Building Permit Applications.
- Prior to occupancy approval, the potability of the water supply must be verified by collection of bacteriological and chemical water samples.
- If submission of plans to the County Review Group is required, a Hydrogeological Study and an Environmental Effects Report must be submitted. For more information contact the Division of Environmental Management at 887-3990.
- In order to subdivide this property, the owner or developer will be required to comply with the subdivision regulations of the State of Maryland and Baltimore County. If there are any questions regarding the subdivision process, please contact the Land Development Section at 887-1762.

Others _____

J. Robert Haines
BUREAU OF WATER QUALITY AND RESOURCE MANAGEMENT

BALTIMORE COUNTY ZONING PLANS ADVISORY COMMITTEE

April 17, 1989

Ms. Cynthia E. Riley
P.O. Box 95
Mt. Carmel Road
Parkton, MD 21120

RE: Item No. 289, Case No. 89-428-SPH
Petitioner: Cynthia E. Riley, et al
Petition for Special Hearing

Dear Ms. Riley:

The Zoning Plans Advisory Committee has reviewed the plans submitted with the above referenced petition. The following comments are not intended to indicate the appropriateness of the zoning action requested, but to assure that all parties are made aware of plans or problems with regard to the development that may have a bearing on this case. Director of Planning may file a written report with the Zoning Commissioner with recommendations as to the suitability of the requested zoning.

Enclosed are all comments submitted from the members of the Committee at this time that offer or request information on your petition. If similar comments from the remaining members are received, I will forward them to you. Otherwise, any comment that is not informative will be placed in the hearing file. This petition was accepted for filing on the date of the enclosed filing certificate and a hearing scheduled accordingly.

IT WOULD BE APPRECIATED IF YOU WOULD RETURN YOUR WRITTEN COMMENTS TO MY OFFICE, ATTENTION: JULIE WINIARSKI. IF YOU HAVE ANY QUESTIONS REGARDING THIS, PLEASE CONTACT HER AT 887-3391.

Very truly yours,
James E. Dyer
JAMES E. DYER
Chairman
Zoning Plans Advisory Committee

JED:jw
Enclosures

LAW OFFICES
LEVIN & GANN
A PROFESSIONAL ASSOCIATION
305 W. CHESAPEAKE AVENUE
TOWSON, MARYLAND 21204
1-321-0600
FAX 301-296-2801


March 21, 1990

RE: Plat of "Jennie's View" - Chickentown Road
Case No. 89-428-SPH
Clarification of Order

Dear Commissioner Nastarowicz:

Enclosed please find the Final Plat of Jennie's View, revised consistent with your Order of January 11, 1990 and our telephone conversation of last week. As we discussed, the note regarding the number of units presently permitted on each lot indicates "dwelling" rather than "density" units.

I have received a telephone call from Anthony L. Brennan, Esquire, counsel to a potential contract purchaser of proposed Lot 1 as shown on the enclosed plat. Mr. Brennan expressed concern regarding the use of "density unit" in your Order and the restriction of proposed Lots 1 and 2 for agricultural uses. Mr. Brennan has asked me to obtain written verification from your office that: 1) a single "dwelling" unit can be constructed on each of the proposed lots; and 2) that uses accessory to the dwelling units i.e. garage, pool etc. are permitted as of right.

I assured Mr. Brennan that the intent of the Order was to permit both a single dwelling unit and uses accessory thereto. However, written verification of this intent is needed to permit restriction of proposed Lots 1 and 2 for agricultural uses. It is anticipated that such verification will definitely be needed to satisfy lender's counsel.

RECEIVED
MAR 22 1990
ZONING OFFICE

Baltimore County
Fire Department
Towson, Maryland 21204-2586
494-4500

Paul H. Reincke
Chief

J. Robert Haines, Zoning Commissioner
Office of Planning & Zoning
Baltimore County Office Building
Towson, Maryland 21204

RE: Property Owner: Cynthia E. Riley; Gregory Cornwell, et ux
Location: 2615 Chickentown Road
Item No.: 289 Zoning Agenda: February 28, 1989

Dennis F. Rasmussen
County Executive

Gentlemen:

Pursuant to your request, the referenced property has been surveyed by this Bureau and the comments below marked with an "X" are applicable and required to be corrected or incorporated into the final plans for the property.

- () 1. Fire hydrants for the referenced property are required and shall be located at intervals or _____ feet along an approved road in accordance with Baltimore County Standards as published by the Department of Public Works.
- () 2. A second means of vehicle access is required for the site.
- (X) 3. The vehicle dead end condition shown at end of lot #1, standard tee turn-around or cul-de-sac required.
EXCESS the maximum allowed by the Fire Department.
- (X) 4. The site shall be made to comply with all applicable parts of the Fire Prevention Code prior to occupancy or beginning of operation.
- (X) 5. The buildings and structures existing or proposed on the site shall comply with all applicable requirements of the National Fire Protection Association Standard No. 101 "Life Safety Code," 1976 edition prior to occupancy.
- () 6. Site plans are approved, as drawn.
- () 7. The Fire Prevention Bureau has no comments at this time.
* Fan handle road shall be 16' in width & support 50,000 lbs. fire apparatus.

REVIEWER: *Paul H. Reincke* 3-11-89 NOTED & APPROVED: *Paul H. Reincke*
Special Inspection Division Fire Prevention Bureau

/s/

LEVIN & GANN, P. A.

Ann M. Nastarowicz, Esquire
Page 2
March 21, 1990

Please provide me, at your earliest convenience, written verification of the above described intent. Should you need additional information, please call me immediately.

Very truly yours,
Howard L. Alderman, Jr.
Howard L. Alderman, Jr.

HIA/lis
Enclosure
cc: Ms. Cynthia Riley
Anthony L. Brennan, Esquire

Baltimore County
Zoning Commissioner
Office of Planning & Zoning
Towson, Maryland 21204
(301) 887-3353

J. Robert Haines
Zoning Commissioner

April 3, 1990

Howard L. Alderman, Jr., Esquire
Levin & Gann
305 W. Chesapeake Avenue
Towson, Maryland 21204

RE: Petition for Special Hearing
SE/S Chickentown Road, 709' SW of North Ruhl Road
(2615 Chickentown Road)
6th Election District - 3rd Councilmanic District
Cynthia E. Riley, et al - Petitioners
Case No. 89-428-SPH

Dear Mr. Alderman:

In response to your letter dated March 21, 1990 and subsequent conversation regarding the above-captioned matter, the following additional comments are offered.

As previously stated, the restrictions contained in the Order issued January 11, 1990 were applied to insure that Lots 1 and 2 were used for agricultural purposes as presented at the hearing. Therefore, the location of any accessory uses to the dwelling units on Lots 1 and 2, as well as the location of the dwelling itself, must be approved by the Department of Environmental Protection and Resource Management and the Office of Planning to insure that they do not interfere with prime and productive soils or agricultural uses. Upon receipt of such documentation, our office will sign off on any permits, provided the accessory uses are in compliance with the Baltimore County Zoning Regulations (B.C.Z.R.) dealing with same, including, but not limited to, Sections 101 and 400 of the B.C.Z.R.

Should you have any further questions on the subject, please do not hesitate to contact me.

Very truly yours,
Ann M. Nastarowicz
ANN M. NASTAROWICZ
Deputy Zoning Commissioner
for Baltimore County

ANN:bjc
cc: File

Baltimore County
Zoning Commissioner
Office of Planning & Zoning
Towson, Maryland 21204
(301) 887-3353

J. Robert Haines
Zoning Commissioner

January 11, 1990

Julius W. Lichter, Esquire
305 W. Chesapeake Avenue, Suite 113
Towson, Maryland 21204

RE: PETITION FOR SPECIAL HEARING
SE/S Chickentown Road, 709' SW of North Ruhl Road
(2615 Chickentown Road)
6th Election District - 3rd Councilmanic District
Cynthia E. Riley, et al - Petitioners
Case No. 89-428-SPH

Dear Mr. Lichter:

Enclosed please find a copy of the decision rendered in the above-captioned matter. The Petition for Special Hearing has been granted in accordance with the attached Order.

In the event any party finds the decision rendered is unfavorable, any party may file an appeal to the County Board of Appeals within thirty (30) days of the date of this Order. For further information on filing an appeal, please contact Ms. Charlotte Radcliffe at 887-3391.

Very truly yours,
Ann M. Nastarowicz
ANN M. NASTAROWICZ
Deputy Zoning Commissioner
for Baltimore County

ANN:bjc
cc: People's Counsel
File

3/14/90 7k Howard
 2 b/c
 address in
 address in
 address in

LAW OFFICES
LEVIN & CANN
 A PROFESSIONAL ASSOCIATION
 305 W. CHESAPEAKE AVENUE
 TOWSON, MARYLAND 21284
 301-321-0500
 FAX 301-298-2800

MARCH 9, 1990

RECEIVED
 MAR 9 1990
ZONING OFFICE

HAND DELIVERED

Ann M. Nastarowicz, Esquire
 Deputy Zoning Commissioner
 Baltimore County Office of Planning and Zoning
 111 West Chesapeake Avenue
 Towson, Maryland 21204

RE: Chickentown Road - Special Hearing
 Final Plat
 Case No. 89-428-SPH
 C. Riley et al. Petitioners

Dear Commissioner Nastarowicz:

In accordance with the restrictions contained in your final order in the above-referenced case, I enclose herewith a paper copy of the final plat for this property. Delays were encountered in securing the necessary approvals of DEPRM, due to the still evolving policy regarding prime and productive agricultural soils and other additions required to the plat by DEPRM.

You will note that all required signatures have been affixed to this plat. Absent any objection from your office, we intend to record this plat among the Land Records of Baltimore County on or before March 14, 1990.

Please call me if you desire any further information or modification to this plat.

Very truly yours,
 Howard E. Alderman, Jr.

HJA/lis
 Enclosure
 cc: Ms. Cynthia Riley

BALTIMORE COUNTY, MARYLAND
 INTER-OFFICE CORRESPONDENCE

TO: J. Robert Balnes, Zoning Commissioner
 DATE: May 3, 1989

FROM: Pat Keller, Deputy Director
 Office of Planning and Zoning

SUBJECT: ZONING ADVISORY COMMITTEE COMMENTS
 Case No. 89-428-SPH
 Item No. 289

Re: Cynthia E. Riley, et al.

RECEIVED
 MAY 3 1989
ZONING OFFICE

This office opposes this petition. Section 1A01.1.A.1.d., Baltimore County Zoning Regulations, states clearly that urban intrusion into productive agricultural areas not only destroys the specific area on which the development occurs, but is incompatible with the agricultural use of the area. Furthermore, Sections 1A00.1.d. and 1A00.1.f., Baltimore County Zoning Regulations, raise concerns about the County's ability to provide services to "urban sprawl" development.

The Zoning Regulations are clear with respect to density and lot size. Section 1A01.3.B.2 states that a lot less than 1 acre may not be created in an RC 2 zone. The 0.46 acre parcel created by deed 8078/823 would not be considered a building lot by this section. The proposal to add a 0.97 acre parcel to a 0.46 acre parcel is not viable because neither parcel has any density inherent to it. In addition, the request violates the intent of the Baltimore County Zoning Regulations and the goals of the RC 2 zone.

This office recommends that any subdivision of the 13.23 acre parcel which remained after the conveyance of the 3.01 acres of land to William E. Smith in deed 8078/823 be done in a manner that best protects the agricultural value of the land. The following recommendations should be considered:

- dwelling and lots will be located in a manner to permit the maximum retention of agricultural value to the remainder of the property;
- wherever possible dwelling should not be located on actively farmed land or prime or productive soils;
- maximum lot size should be three acres but still subject to one dwelling per 50 acres maximum density per parcel;
- building setbacks should be a minimum of 100' from a lot line, which borders farmland in prime or productive soils;
- dwellings should be located along existing roads unless use of a panhandle is necessary to comply with a. or b. listed above; and
- lots located along existing roads should provide, when possible and when not in conflict with the other standards, for common access to reduce road cuts.

LEGAL 8 0 7 8 PAGE 8 2 0
 C-5045-88

COPY

This Deed, Made This 30th day of November

in the year one thousand nine hundred and eighty-eight by and between
 GLENN ELMOOD McCULLOUGH

of Baltimore County, State of Maryland, party of the first part, and
 GREGORY S. CORNWELL and CAROL M. CORNWELL, his wife, and CYNTHIA E. RILEY, parties of the second part.

WITNESSETH, That in consideration of the sum of ONE HUNDRED FIFTY THOUSAND DOLLARS (\$150,000.00) and other good and valuable considerations, the receipt whereof is hereby acknowledged,

the said party of the first part

does grant and convey to the said Gregory S. Cornwell and Carol M. Cornwell, his wife, as tenants by the entireties, their assigns, the survivor of them and such survivor's personal representatives and assigns, as to an undivided one-half interest; and to the said Cynthia E. Riley, her personal representatives and assigns, as to the remaining undivided one-half interest

persons in fee simple, all that lot of ground situate in Baltimore County, State of Maryland,

and described as follows, that is to say:
 FOR DESCRIPTION SEE EXHIBIT "A" ATTACHED HERETO AND MADE A PART HEREOF.

AGRICULTURAL TRANSFER TAX NOT APPLICABLE - LETTER OF INTENT SIGNATURE DATE 5/1/89

RECEIVED FOR TRANSFER State Dept. of Assessments & Taxation for Baltimore County JH 11/89

RECEIVED FOR TRANSFER SH CLECK 11/15/89 85079C CORN 01 18 89

RECEIVED FOR TRANSFER SH CLECK 11/15/89 85079C CORN 01 18 89

PEPPER'S EXHIBIT 3

B B 012*****24000DB 50322

LEGAL 8 0 7 8 PAGE 8 2 3
 C-5045-88

COPY

This Deed, Made This 30th day of November

in the year one thousand nine hundred and eighty-eight by and between
 WILLIAM KENNETH SMITH and ELVA MAY SMITH, his wife,

of Baltimore County, State of Maryland, parties of the first part, and
 GREGORY S. CORNWELL and CAROL M. CORNWELL, his wife, and CYNTHIA E. RILEY, parties of the second part.

WITNESSETH, That in consideration of the sum of No Consideration and other good and valuable considerations, the receipt whereof is hereby acknowledged,

the said parties of the first part

do grant and convey to the said Gregory S. Cornwell and Carol M. Cornwell, his wife, as tenants by the entireties, their assigns, the survivor of them and such survivor's personal representatives and assigns, as to an undivided one-half interest; and to the said Cynthia E. Riley, her personal representatives and assigns, as to the remaining undivided one-half interest

persons in fee simple, all that lot of ground situate in Baltimore County, State of Maryland,

and described as follows, that is to say:
 FOR DESCRIPTION SEE EXHIBIT "A" ATTACHED HERETO AND MADE A PART HEREOF.

RECEIVED FOR TRANSFER SH CLECK 11/15/89 85079C CORN 01 18 89

RECEIVED FOR TRANSFER SH CLECK 11/15/89 85079C CORN 01 18 89

PEPPER'S EXHIBIT 4

B B 015*****1E0DB 50322

LEGAL 8 0 7 8 PAGE 8 2 6
 C-5045-88

COPY

This Deed, Made This 30th day of November

in the year one thousand nine hundred and eighty-eight by and between
 GREGORY S. CORNWELL, CAROL M. CORNWELL, his wife, and CYNTHIA E. RILEY,

of Baltimore County, State of Maryland, parties of the first part, and
 WILLIAM KENNETH SMITH and ELVA MAY SMITH, his wife, parties of the second part.

WITNESSETH, That in consideration of the sum of ZERO (\$0) Dollars, and other good and valuable considerations, the receipt whereof is hereby acknowledged,

the said parties of the first part

do grant and convey to the said parties of the second part, as tenants by the entireties, their assigns, the survivor of them and the survivor's personal representatives/successors and assigns

in fee simple, all that lot of ground situate in Baltimore County

and described as follows, that is to say:
 FOR DESCRIPTION: See Exhibit "A" attached hereto and made a part hereof B RCF 17.00
 LEED SH CLECK 11.15.89 85079C CORN 01 18 89

RECEIVED FOR TRANSFER State Dept. of Assessments & Taxation for Baltimore County JH 11/89

PEPPER'S EXHIBIT 3

AGRICULTURAL TRANSFER TAX NOT APPLICABLE - LETTER OF INTENT SIGNATURE DATE 5/1/89

B B 011*****1E0DB 50322

Proposed Revision 14 Dec 88
 RSD-10 SUBDIVIDING R.C.-2 ZONED LAND (See Also RSD-2 & RSD-8)

Subdivision or further subdividing of legally existing R.C.-2 zoned lots of record prior to Bill 178-79 (effective 11/25/79) is permitted provided that:

only the most recent deed shall be used to determine the number of lots of record and that;

the lots recorded met the existing zoning regulations at that time.

If the property is recorded by multiple deeds or the deed contains multiple parcels, or the subdivision needs further clarification, the following may be required at the discretion of the Zoning Commissioner:

- To properly identify the parcels, a property plat should be prepared listing and color coding each parcel according to the description in the deed.
- The plats, deeds, and other supporting documentation should be prepared and certified by either a land surveyor, registered professional engineer or title attorney.
- All of the above information and documents should be submitted for review at least 15 working days prior to zoning approval or the C.R.G. meeting.

When legally existing parcels or deeds qualify to be subdivided or resubdivided, each separate parcel must be subdivided individually.

If the intent is to reconfigure the existing lots, the main purpose must be for the protection and preservation of farm land and not to create "more uniform" lots for homesites.

See the Following Cases:
 89-428-SPH
 88-314-SPH - 88-227 SPH
 85-281-SPH
 85-104-SPH

LEGAL 8 0 7 8 PAGE 8 2 6
 C-5045-88

COPY

This Deed, Made This 30th day of November

in the year one thousand nine hundred and eighty-eight by and between
 GREGORY S. CORNWELL, CAROL M. CORNWELL, his wife, and CYNTHIA E. RILEY,

of Baltimore County, State of Maryland, parties of the first part, and
 WILLIAM KENNETH SMITH and ELVA MAY SMITH, his wife, parties of the second part.

WITNESSETH, That in consideration of the sum of ZERO (\$0) Dollars, and other good and valuable considerations, the receipt whereof is hereby acknowledged,

the said parties of the first part

do grant and convey to the said parties of the second part, as tenants by the entireties, their assigns, the survivor of them and the survivor's personal representatives/successors and assigns

in fee simple, all that lot of ground situate in Baltimore County

and described as follows, that is to say:
 FOR DESCRIPTION: See Exhibit "A" attached hereto and made a part hereof B RCF 17.00
 LEED SH CLECK 11.15.89 85079C CORN 01 18 89


RECEIVED FOR TRANSFER State Dept. of Assessments & Taxation for Baltimore County JH 11/89

RECEIVED FOR TRANSFER SH CLECK 11/15/89 85079C CORN 01 18 89

PEPPER'S EXHIBIT 3

AGRICULTURAL TRANSFER TAX NOT APPLICABLE - LETTER OF INTENT SIGNATURE DATE 5/1/89

B B 011*****1E0DB 50322

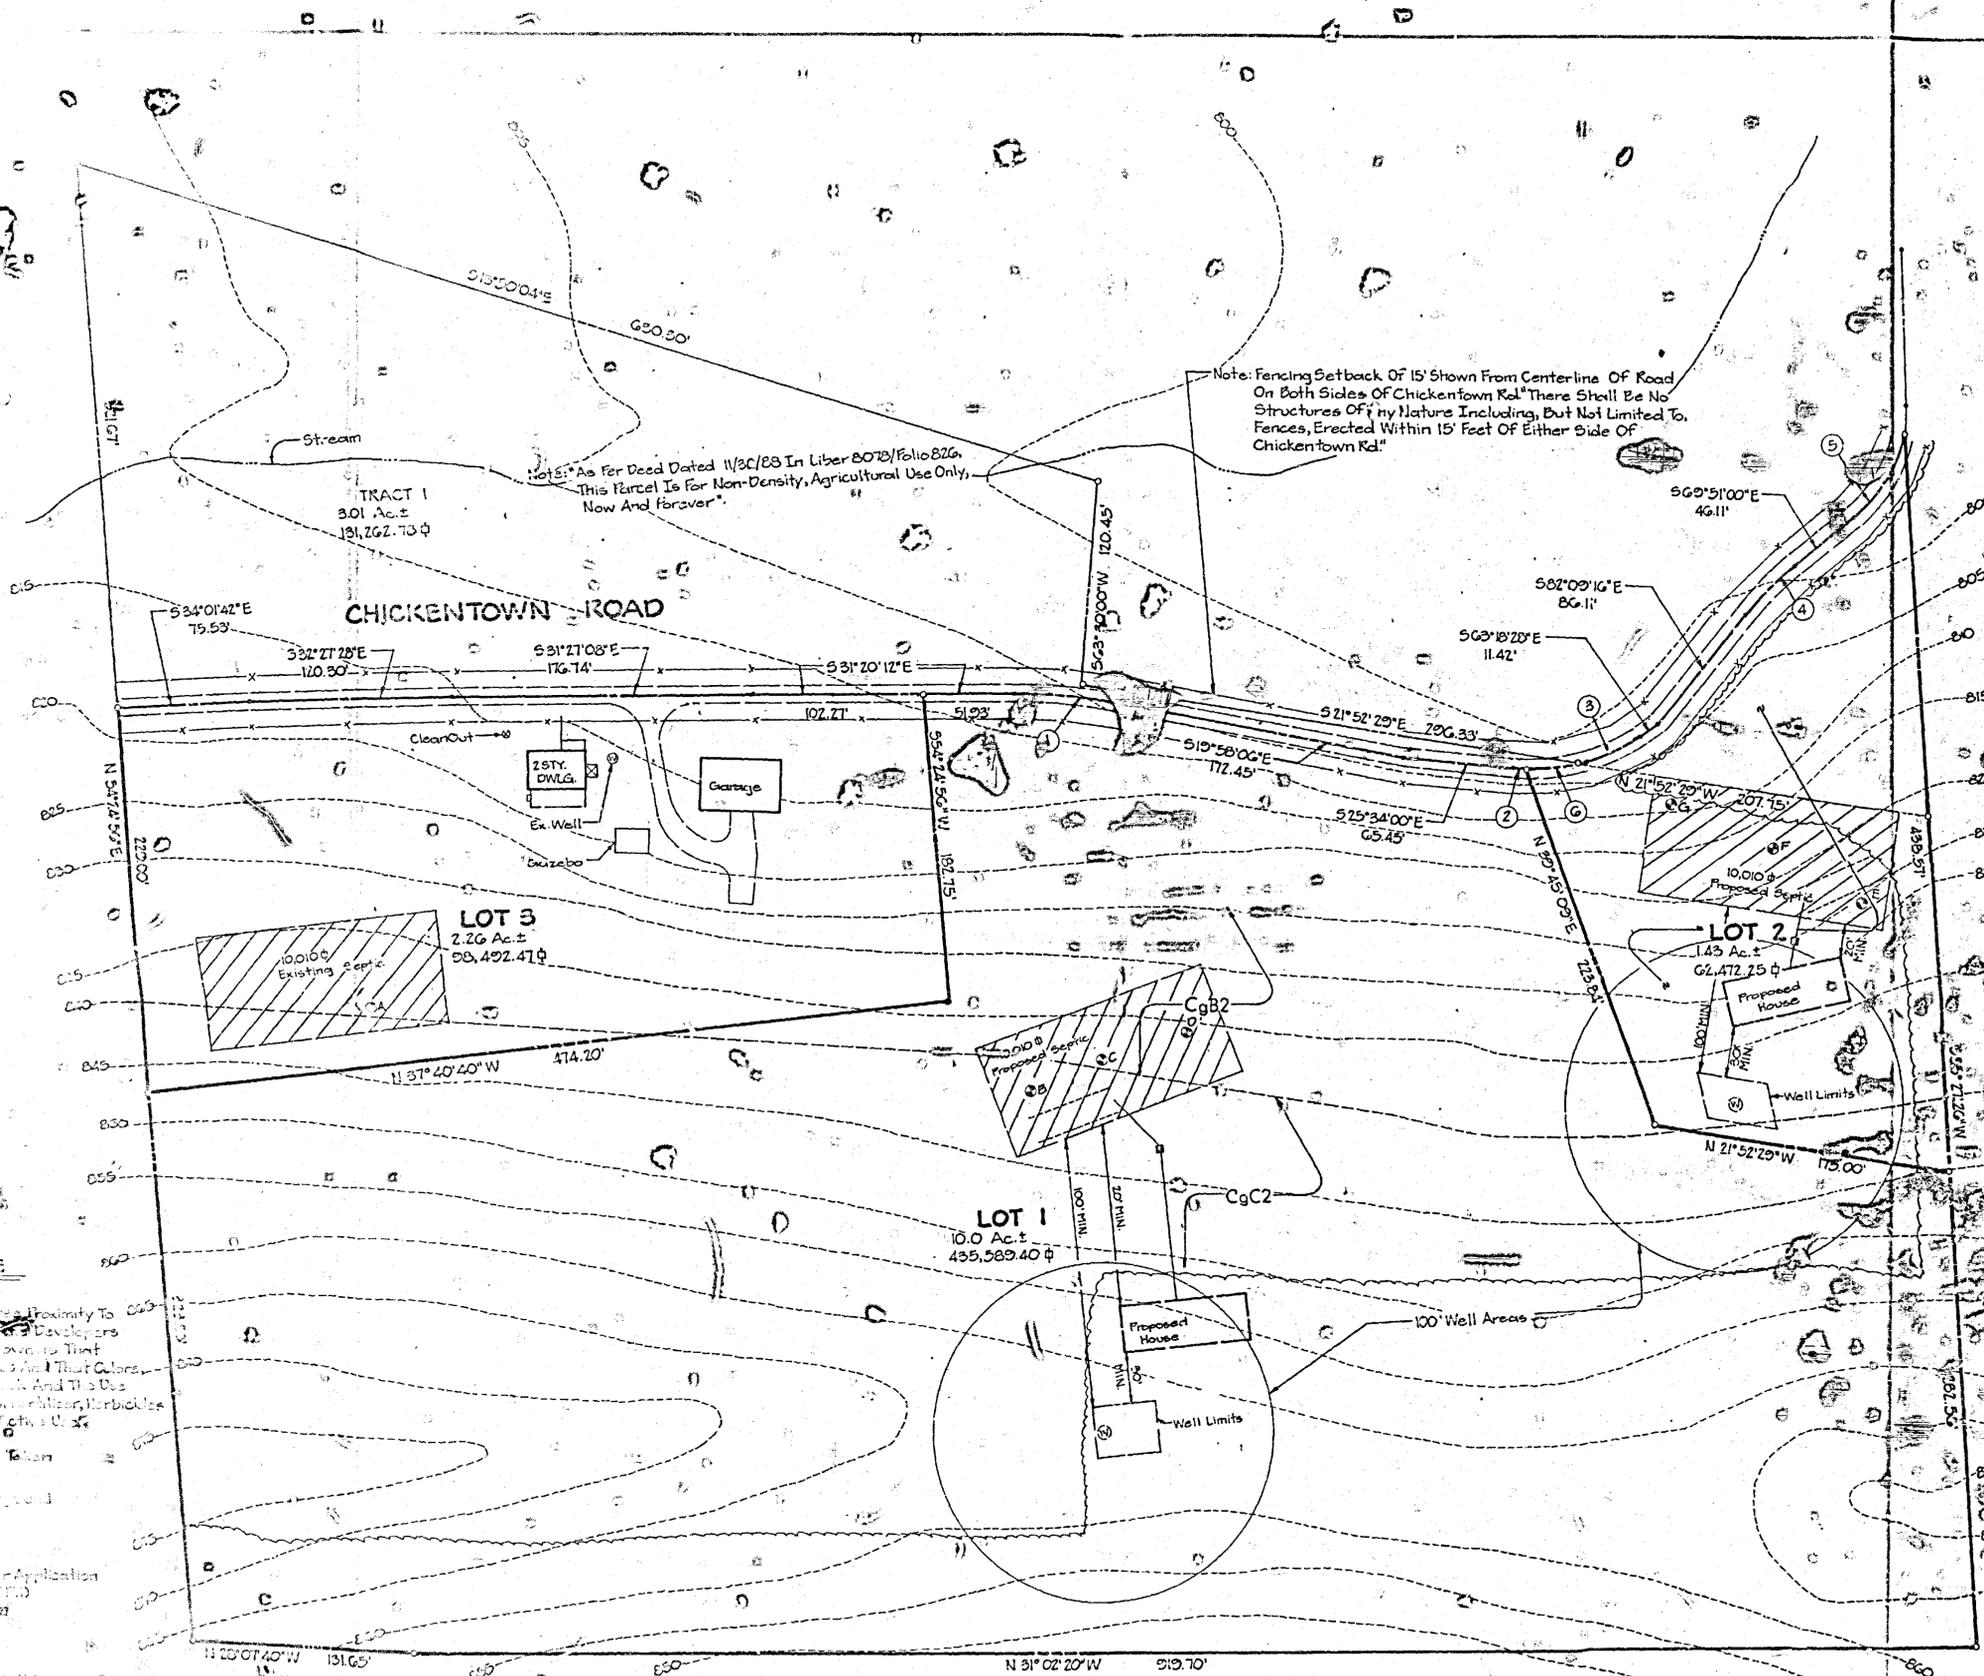

Note: Fencing Setback Of 15' Shown From Centerline Of Road On Both Sides Of Chicken Town Rd. There Shall Be No Structures Of Any Nature, Including, But Not Limited To, Fences, Erected Within 15' Feet Of Either Side Of Chicken Town Rd.

Note: As Per Deed Dated 11/30/83 In Liber 8078/Folio 826, This Parcel Is For Non-Density, Agricultural Use Only, Now And Forever.

NOTE: This plat is a final plat and is subject to the provisions of the Subdivision Control Act, Annotated Code of Maryland, Section 2-108, and the Regulations of the State Board of Survey, Code of Regulations, Section 29.

CURVE DATA						
CURVE NO.	DELTA	RADIUS	ARC	TAN	CHORD	BEARING
NO. ①	11° 22' 07"	301.40'	59.80'	30.0'	59.71'	S 25° 39' 09" E
NO. ②	05° 19' 55"	117.03'	10.89'	5.45'	10.89'	S 28° 13' 57" E
NO. ③	32° 24' 34"	117.03'	66.20'	34.01'	65.32'	S 47° 06' 11" E
NO. ④	12° 18' 16"	135.54'	39.85'	20.0'	39.78'	S 76° 00' 08" E
NO. ⑤	42° 13' 29"	80.42'	59.38'	31.14'	58.04'	N 88° 59' 46" E
NO. ⑥	14° 04' 36"	117.03'	28.75'	14.45'	28.03'	S 37° 56' 07" E

OWNERS CERTIFICATE:
 THE UNDERSIGNED, OWNER OF THE LAND SHOWN ON THIS PLAT, HEREBY CERTIFIES THAT, TO THE BEST OF ITS KNOWLEDGE, THE REQUIREMENT OF SUBSECTION (C) OF SECTION 2-108 OF THE REAL PROPERTY ARTICLE OF THE ANNOTATED CODE OF MARYLAND, HAS BEEN COMPLIED WITH, IN SO FAR AS SAME CONCERNS THE MAKING OF THE PLAT AND THE SETTING OF THE MARKERS.
 Signature: *William Kenneth Smith*
 Date: 2-12-90

SURVEYORS CERTIFICATE:
 THE UNDERSIGNED, A REGISTERED LAND SURVEYOR OF THE STATE OF MARYLAND, DOGS HEREBY CERTIFY THAT HE IS THE SURVEYOR WHO PREPARED THIS PLAT AND THAT THE LAND SHOWN ON THIS PLAT HAS BEEN LAD OUT, AND THAT THE PLAT THEREOF HAS BEEN PREPARED, IN COMPLIANCE WITH SUBSECTION (C) OF SECTION 2-108 OF THE REAL PROPERTY ARTICLE OF THE ANNOTATED CODE OF MARYLAND, PARTICULARLY IN SO FAR AS SAME CONCERNS THE MAKING OF THE PLAT AND SETTING OF THE MARKERS.
 Date: 2-12-90

FINAL PLAT
"JENNIE'S VIEW"
 Located OFF OF
 CHICKENTOWN ROAD
 Sixth Election District
 Baltimore County, Maryland

WHITNEY BAILEY & MAGNANI CONSULTING ENGINEERS
 1850 YORK ROAD
 TIMONUM, MD. 21083
 301-252-8500

DATE OF FIELD SURVEY: 2-12-90
 DRAWN BY: HAV
 CHECKED BY: WISEWY
 DATE: 2-12-90



1. ALL DIMENSIONS TO CENTERLINE UNLESS NOTED OTHERWISE.
LEGEND

	ESTABLISHED BOUNDARY LINE
	CENTER-LINE RD. (DEED)
	PREVIOUS BOUNDARY LINE
	PERCOLATION TEST
	NO. 4 BERM CUT
	ST. 1 FOU 3
	BRICK WELLS
	EXIST. WELLS / PROPOSED WELLS





FINAL PLAT


CONSULTING
 ENGINEERS
 1450 YORK ROAD
 TIMONUM, MD. 21093
 301-222-6000

DANAYN
 COX
 WACHMAN

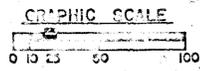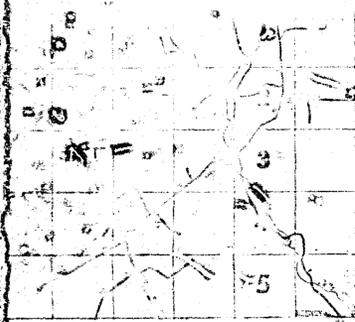

Chickentown Road (Public)

McCullough to Cornwall/Riley 8372/820 16.24 ± Ac

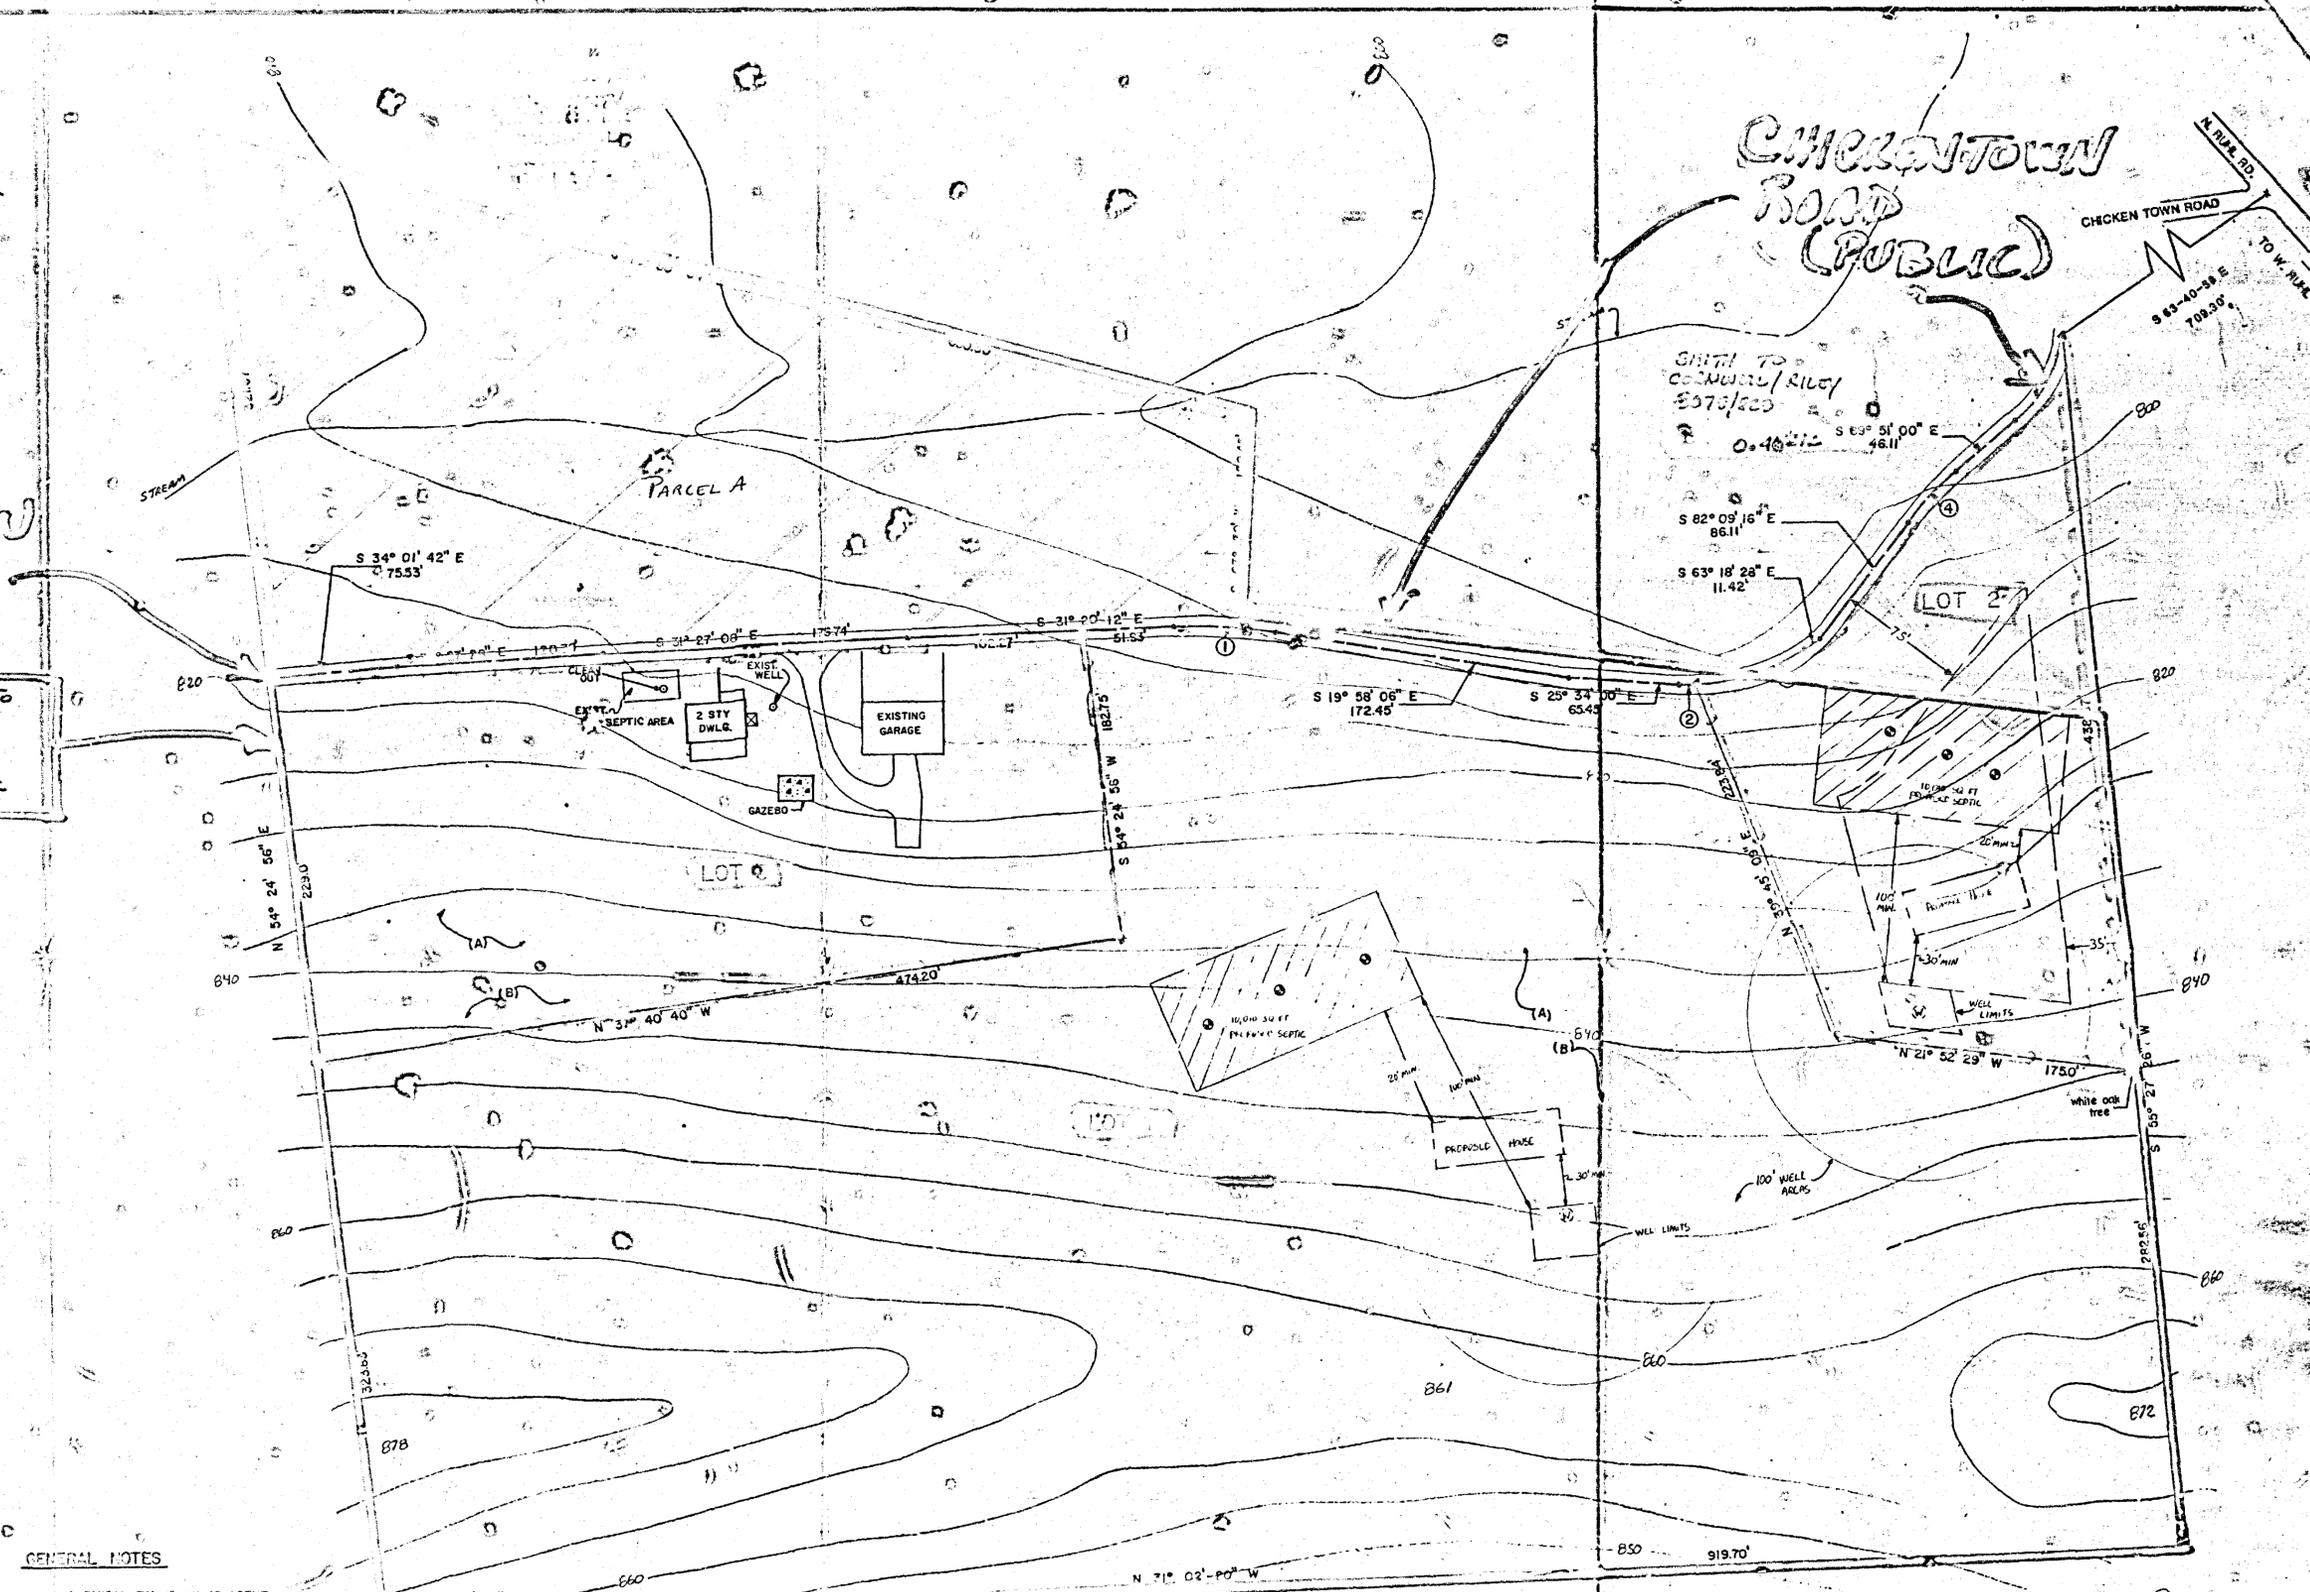

GENERAL NOTES

- NO KNOWN OIL OR CHEMICAL TANKS ON ADJACENT PROPERTIES.
 - NO EXISTING PUBLIC WATER OR SEWER LINES.
 - PROPERTY IS LOCATED IN ZONE "RS-2".
 - DEVELOPER IS: COX, RILEY, GREGORY & CARROL CORNWELL REALTY, L.P.
 - ACERAGE:

LOT 1	435,503.40 ±	10.0 AC ±
LOT 2	62,472.25 ±	1.43 AC ±
LOT 3	93,492.47 ±	2.26 AC ±
 - SOIL TYPES:

C ₂ C ₂	below contour line 840 (A)
C ₂ C ₂	above 840 (C)
- REVISED DATE 1/17/87 *gan*

LEGEND

	ESTABLISHED BOUNDARY LINE
	CENTER-LINE RD. (DEED)
	PREVIOUS BOUNDARY LINE
	PERCOLATION TEST
	NO. 4 REDAR SET
	STONE FOUND
	PK NAIL SET
	EXIST. WELL / PROPOSED WELL

CURVE DATA

CURVE NO.	DELTA	RADIUS	ARC	TAN	CHORD	BEARING
NO. ①	11° 22' 07"	301.40'	53.00'	30.0'	53.71'	S 25° 39' 09" E
NO. ②	00° 19' 25"	117.63'	10.89'	5.45'	10.89'	S 23° 13' 57" E
NO. ③	22° 24' 34"	117.03'	66.20'	34.01'	65.32'	S 47° 05' 11" E
NO. ④	12° 18' 15"	103.54'	33.65'	12.00'	33.76'	S 70° 00' 00" E
NO. ⑤	42° 13' 23"	53.42'	53.39'	31.14'	55.04'	N 65° 23' 46" E

 DATE 1/17/87




FINAL PLAT
 of
 "JENNIE'S VIEW"
 Located off of
 CHICKEN TOWN ROAD
 SIXTH ELECTION DISTRICT
 BALTIMORE COUNTY, MARYLAND.

WHITNEY BAILEY COX MAGNANI
 CONSULTING ENGINEERS
 1850 YORK ROAD
 TIMONUM, MD. 21093
 301-252-6060

DATE OF FIELD SURVEY 11/18/83 SCALE 1"=40'
 DRAWN BY M. FELDMAN CHECKED BY J. WATNE DATE 12/20/83
 WDC/ML 83-236-09 SHEET NO. 1 OF 1


Ref Ex 2

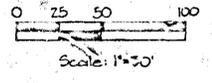

Note: Basis Of Bearing Based On Deed G039/033

Note: As Per Deed Dated 11/30/83 In Liber 8078/Folio 826, This Parcel Is For Non-Density, Agricultural Use Only, Now And Forever.

Note: Fencing Setback Of 15' Shown From Center-line Of Road On Both Sides Of Chickentown Rd. There Shall Be No Structures Of Any Nature Including, But Not Limited To, Fences, Erected Within 15' Feet Of Either Side Of Chickentown Rd.

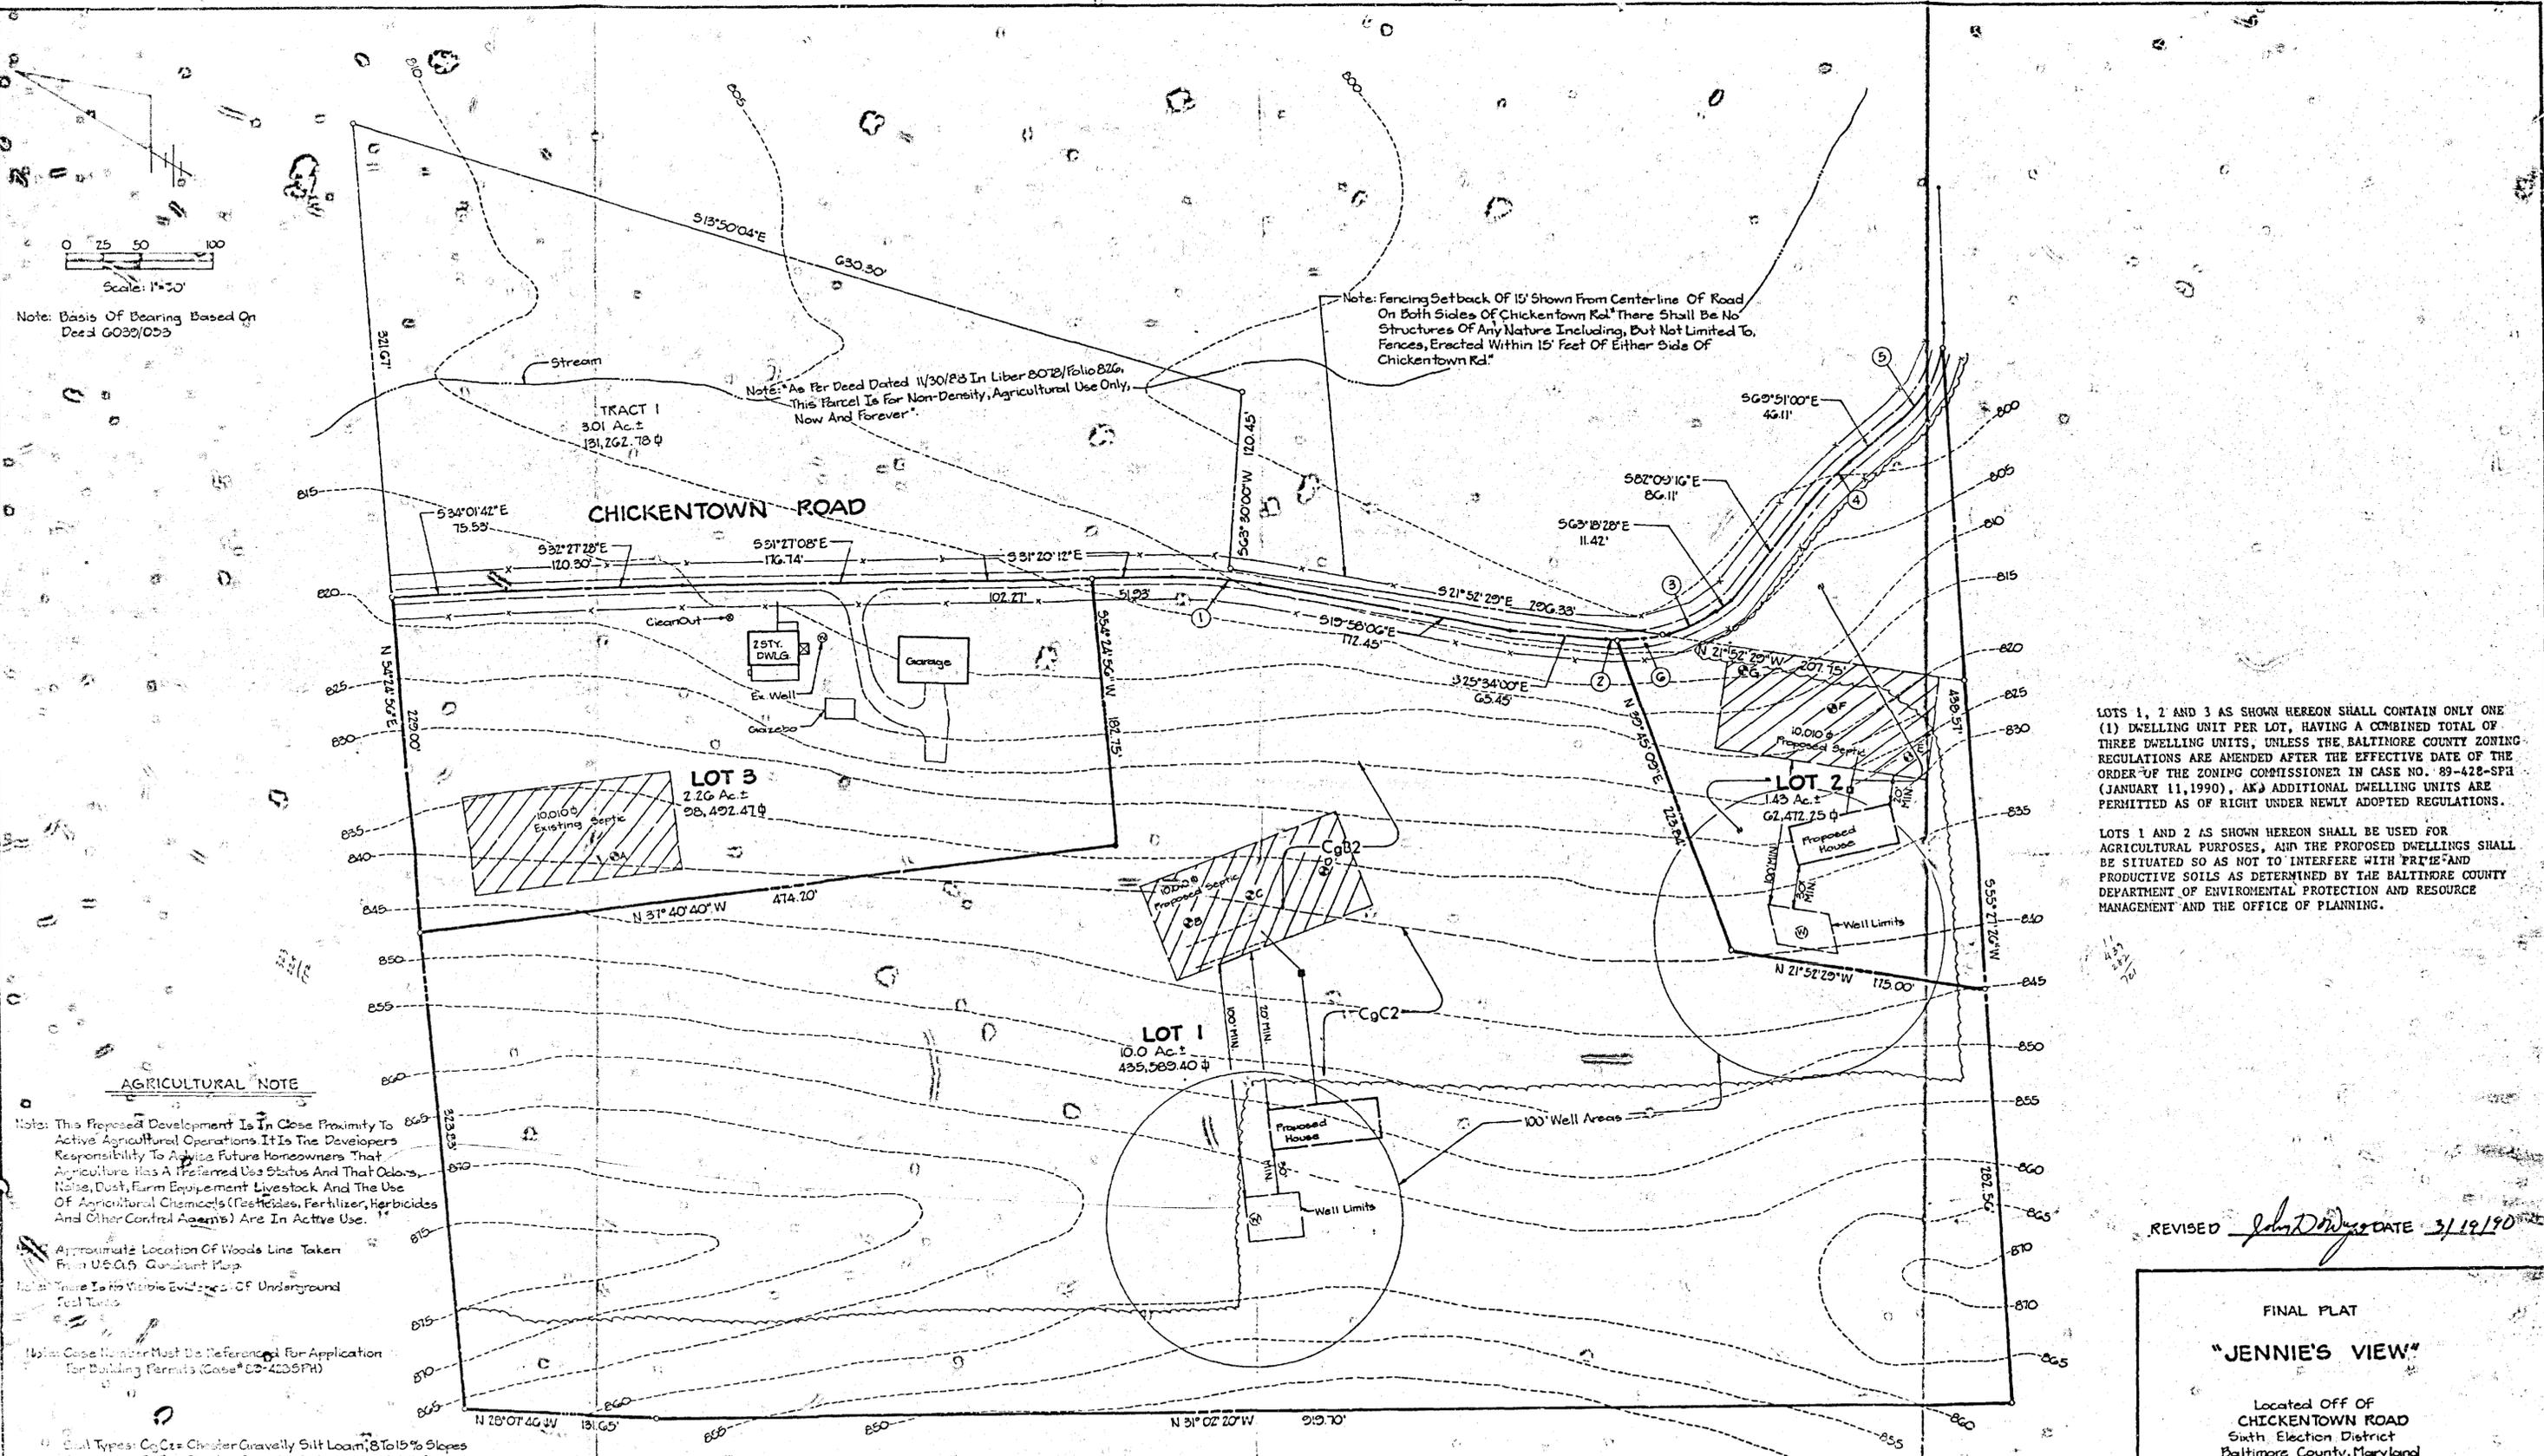

LOTS 1, 2 AND 3 AS SHOWN HEREON SHALL CONTAIN ONLY ONE (1) DWELLING UNIT PER LOT, HAVING A COMBINED TOTAL OF THREE DWELLING UNITS, UNLESS THE BALTIMORE COUNTY ZONING REGULATIONS ARE AMENDED AFTER THE EFFECTIVE DATE OF THE ORDER OF THE ZONING COMMISSIONER IN CASE NO. 89-428-SPH (JANUARY 11, 1990), AND ADDITIONAL DWELLING UNITS ARE PERMITTED AS OF RIGHT UNDER NEWLY ADOPTED REGULATIONS.

LOTS 1 AND 2 AS SHOWN HEREON SHALL BE USED FOR AGRICULTURAL PURPOSES, AND THE PROPOSED DWELLINGS SHALL BE SITUATED SO AS NOT TO INTERFERE WITH PRIME AND PRODUCTIVE SOILS AS DETERMINED BY THE BALTIMORE COUNTY DEPARTMENT OF ENVIRONMENTAL PROTECTION AND RESOURCE MANAGEMENT AND THE OFFICE OF PLANNING.

AGRICULTURAL NOTE

Note: This Proposed Development Is In Close Proximity To Active Agricultural Operations It Is The Developers Responsibility To Advise Future Homeowners That Agriculture Has A Preferred Use Status And That Odors, Noise, Dust, Farm Equipment, Livestock And The Use Of Agricultural Chemicals (Pesticides, Fertilizer, Herbicides And Other Control Agents) Are In Active Use.

Approximate Location Of Woods Line Taken From U.S.G.S. Contour Map

Note: There Is No Visible Evidence Of Underground Test Tents

Note: Case Number Must Be Referenced For Application For Building Permits (Case# 89-428-SPH)

Soil Types: CgCz= Chester Gravelly Silt Loam, 8 To 15% Slopes
CgBz= Chester Gravelly Silt Loam, 3 To 8% Slopes

REVISED *John D. Wynn* DATE 3/19/90

FINAL PLAT
"JENNIE'S VIEW"

Located Off Of
CHICKENTOWN ROAD
Sixth Election District
Baltimore County, Maryland

WHITNEY BAILEY COX MAGNANI CONSULTING ENGINEERS
1850 YORK ROAD
TIMONUM, MD. 21093
301-252-6060

CURVE DATA						
CURVE NO.	DELTA	RADIUS	ARC	TAN	CHORD	BEARING
NO. (1)	11° 22' 07"	301.40'	59.60'	30.0'	59.71'	S 25° 39' 03" E
NO. (2)	05° 19' 55"	117.03'	10.89'	5.45'	10.89'	S 28° 13' 57" E
NO. (3)	32° 24' 34"	117.03'	66.20'	34.01'	65.32'	S 47° 05' 11" E
NO. (4)	12° 18' 16"	135.54'	39.85'	20.0'	139.78'	S 76° 00' 05" E
NO. (5)	42° 18' 29"	80.42'	59.38'	31.54'	59.04'	N 89° 53' 40" E
NO. (6)	14° 04' 36"	117.03'	28.75'	14.45'	28.66'	S 37° 50' 00" E

OWNERS CERTIFICATE:

THE UNDERSIGNED, OWNER OF THE LAND SHOWN ON THIS PLAT, HEREBY CERTIFIES THAT, TO THE BEST OF HIS KNOWLEDGE, THE REQUIREMENTS OF SUBSECTION (C) OF SECTION 3-108 OF THE REAL PROPERTY ARTICLE OF THE ANNOTATED CODE OF MARYLAND HAS BEEN COMPLIED WITH, INsofar AS SAME CONCERN THE MAPPING OF THE PLAT AND THE SETTING OF THE MARKERS.

John D. Wynn
DATE: 2/22/90

REVISOR'S CERTIFICATE:

THE UNDERSIGNED, A REGISTERED LAND SURVEYOR OF THE STATE OF MARYLAND, DOES HEREBY CERTIFY THAT HE IS THE SURVEYOR WHO PREPARED THIS PLAT AND THAT THE LAND SHOWN ON THIS PLAT HAS BEEN LAD OUT AND THE PLAT THEREOF HAS BEEN PREPARED IN COMPLIANCE WITH SUBSECTION (C) OF SECTION 3-103 OF THE REAL PROPERTY ARTICLE OF THE ANNOTATED CODE OF MARYLAND, PARTICULARLY INsofar AS SAME CONCERN THE MAPPING OF THE PLAT AND SETTING OF THE MARKERS.

John D. Wynn
DATE: 2/22/90

DIRECTOR, DEPT. OF ENVIRONMENTAL PROTECTION AND RESOURCE MANAGEMENT
DATE: 3-5-90
P.S.

DATE OF FIELD SURVEY 2/11/90 SCALE 1"=30'
DRAWN BY MAV CHECKED BY JWW/SEV DATE 2/18/90
S.B.C.M. 89-428-SPH SHEET NO. 10

